

notes ·

NOTE:
EVERY EFFORT HAS
BEEN MADE TO
ENSURE THE
ACCURACY OF THESE
PLANS, HOWEVER IF
A NEW FITOUT
INCLUDES A SPECIFIC
CLEARANCE
REQUIREMENT (IE.
FIRE EGRESS WIDTH,
ETC) THE DESIGNER
IS TO CHECK SUCH
CRITICAL
DIMENSIONS ON SITE
THEMSELVES.

A AS BUILT PLANS
08/11/2013
revision ·

project ·
As Built Plans
54 WELLESLEY ST
AUCKLAND CBD
for C.P. GROUP



sheet ·
AS BUILT PLAN
LEVEL 3

scale · 1:50 @ A1

drawing no · **A1-200**
revision no · **A**

DO NOT SCALE.
contractor must verify all dimensions
on site prior to commencing work.
copyright © CAAHTstudio
ARCHITECTS LTD

AS BUILT

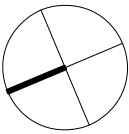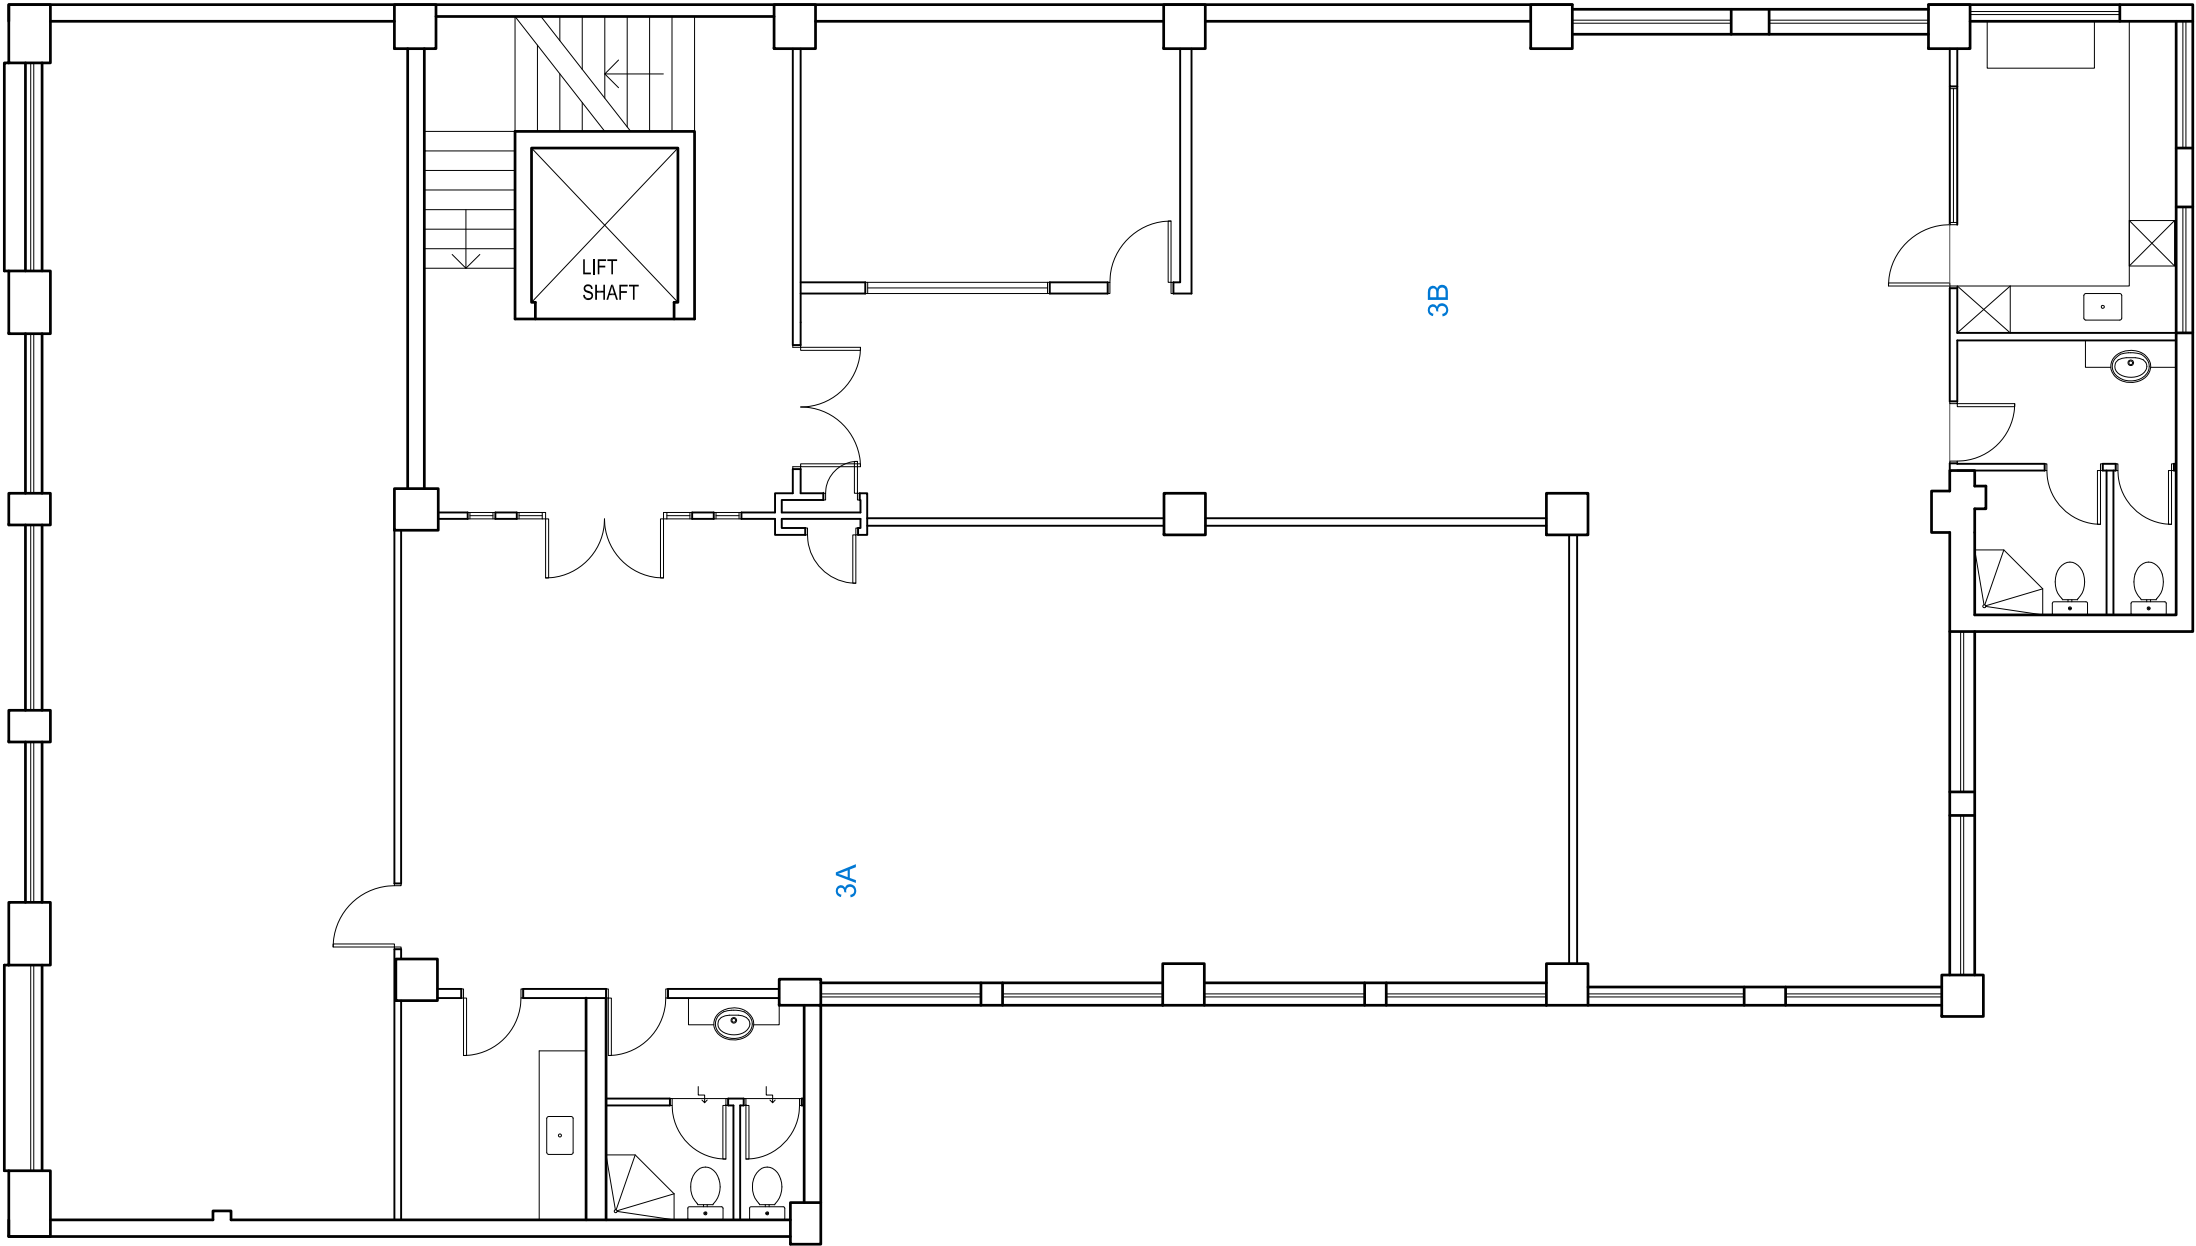

1 LEVEL 3 PLAN
- SCALE: 1:50 @ A1, 1:100 @ A3